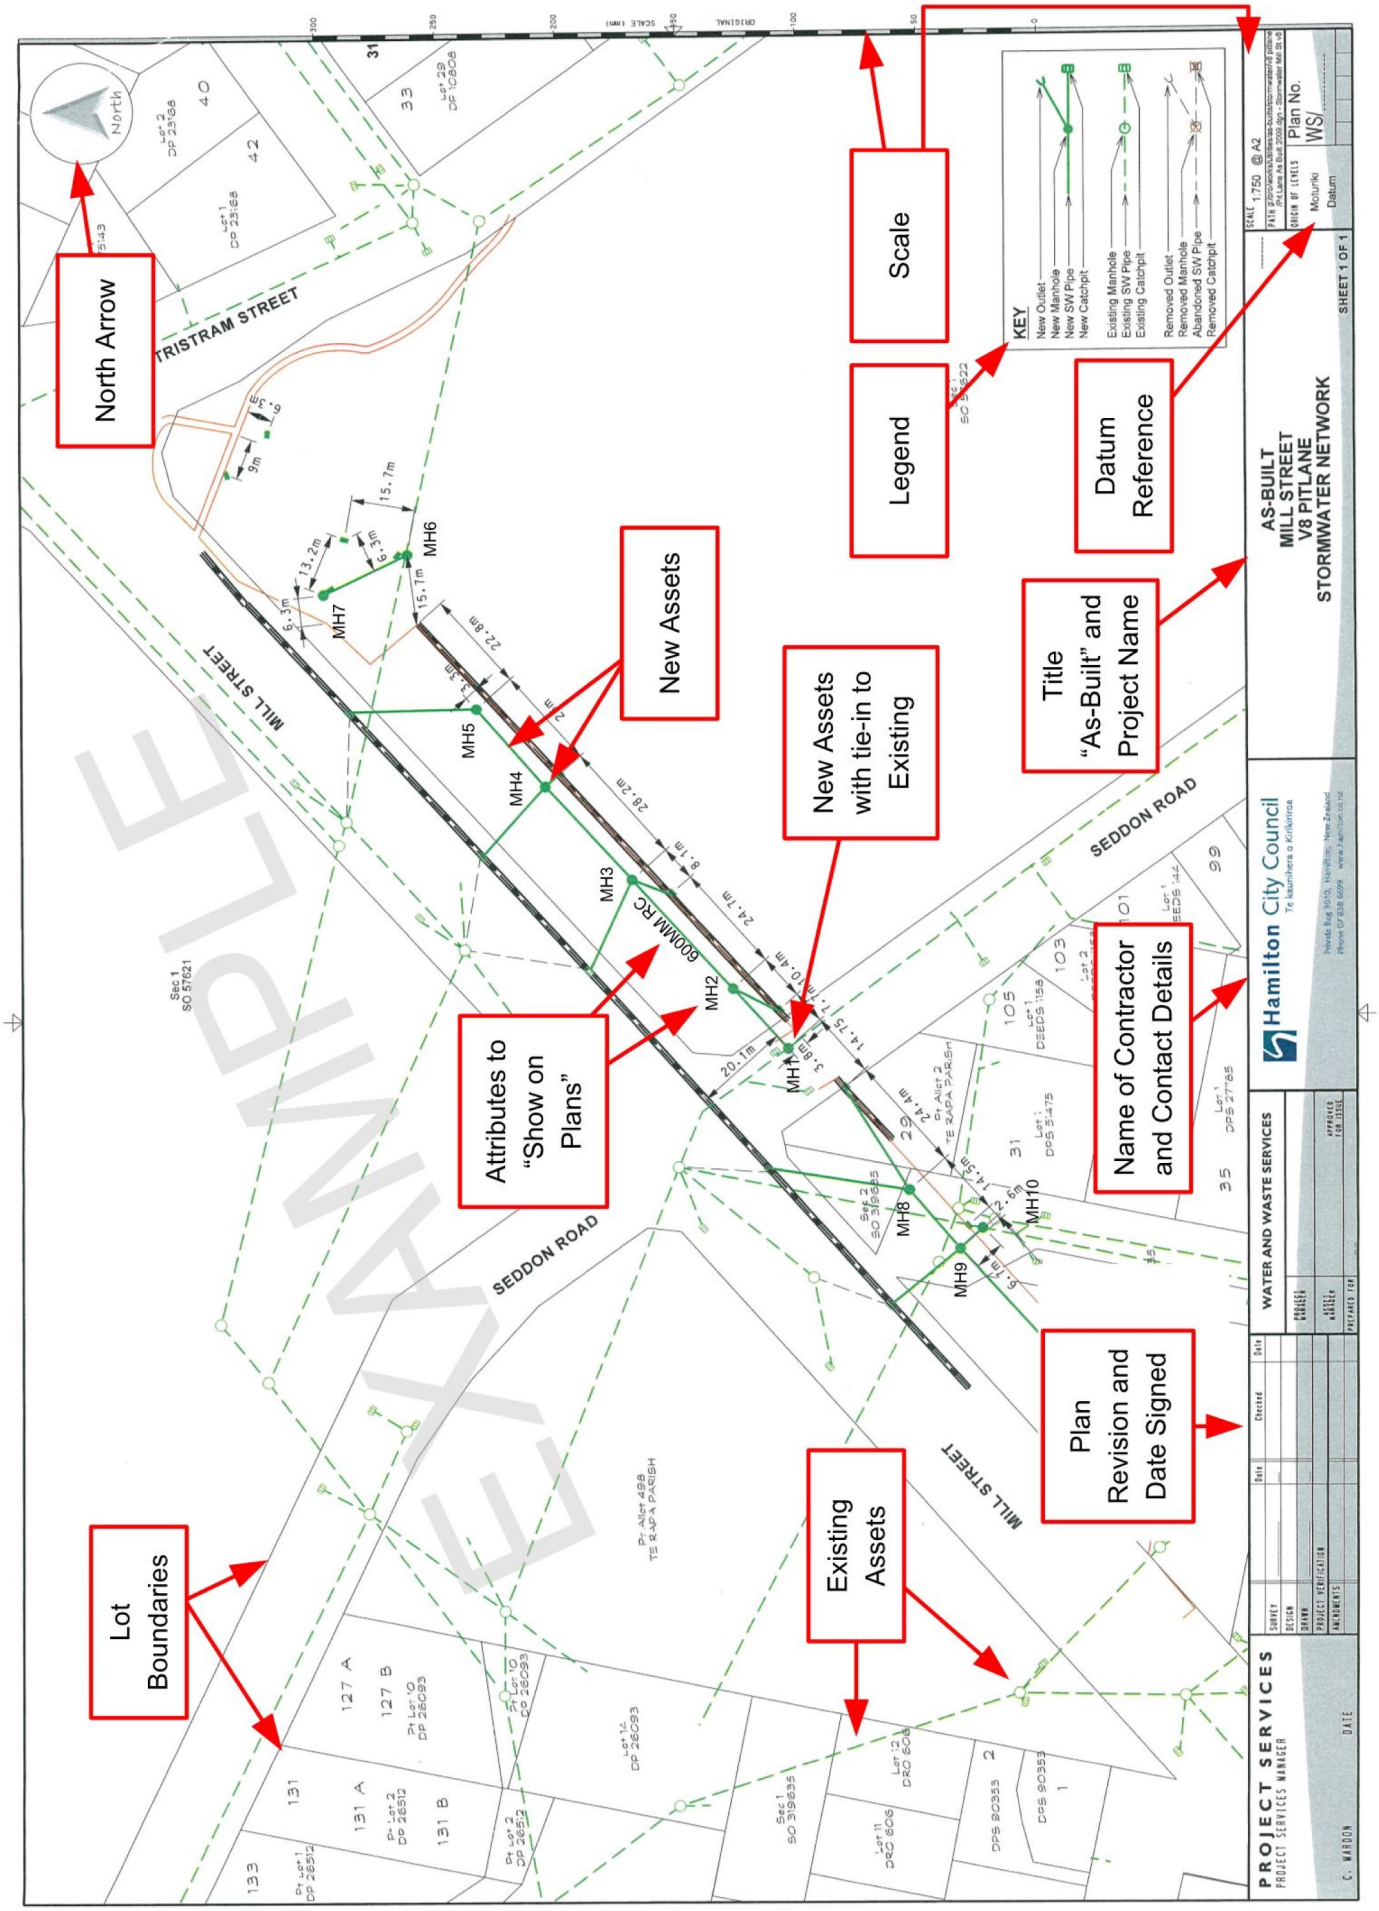

COLAB
BETTER TOGETHER

STORMWATER AS-BUILT PLAN