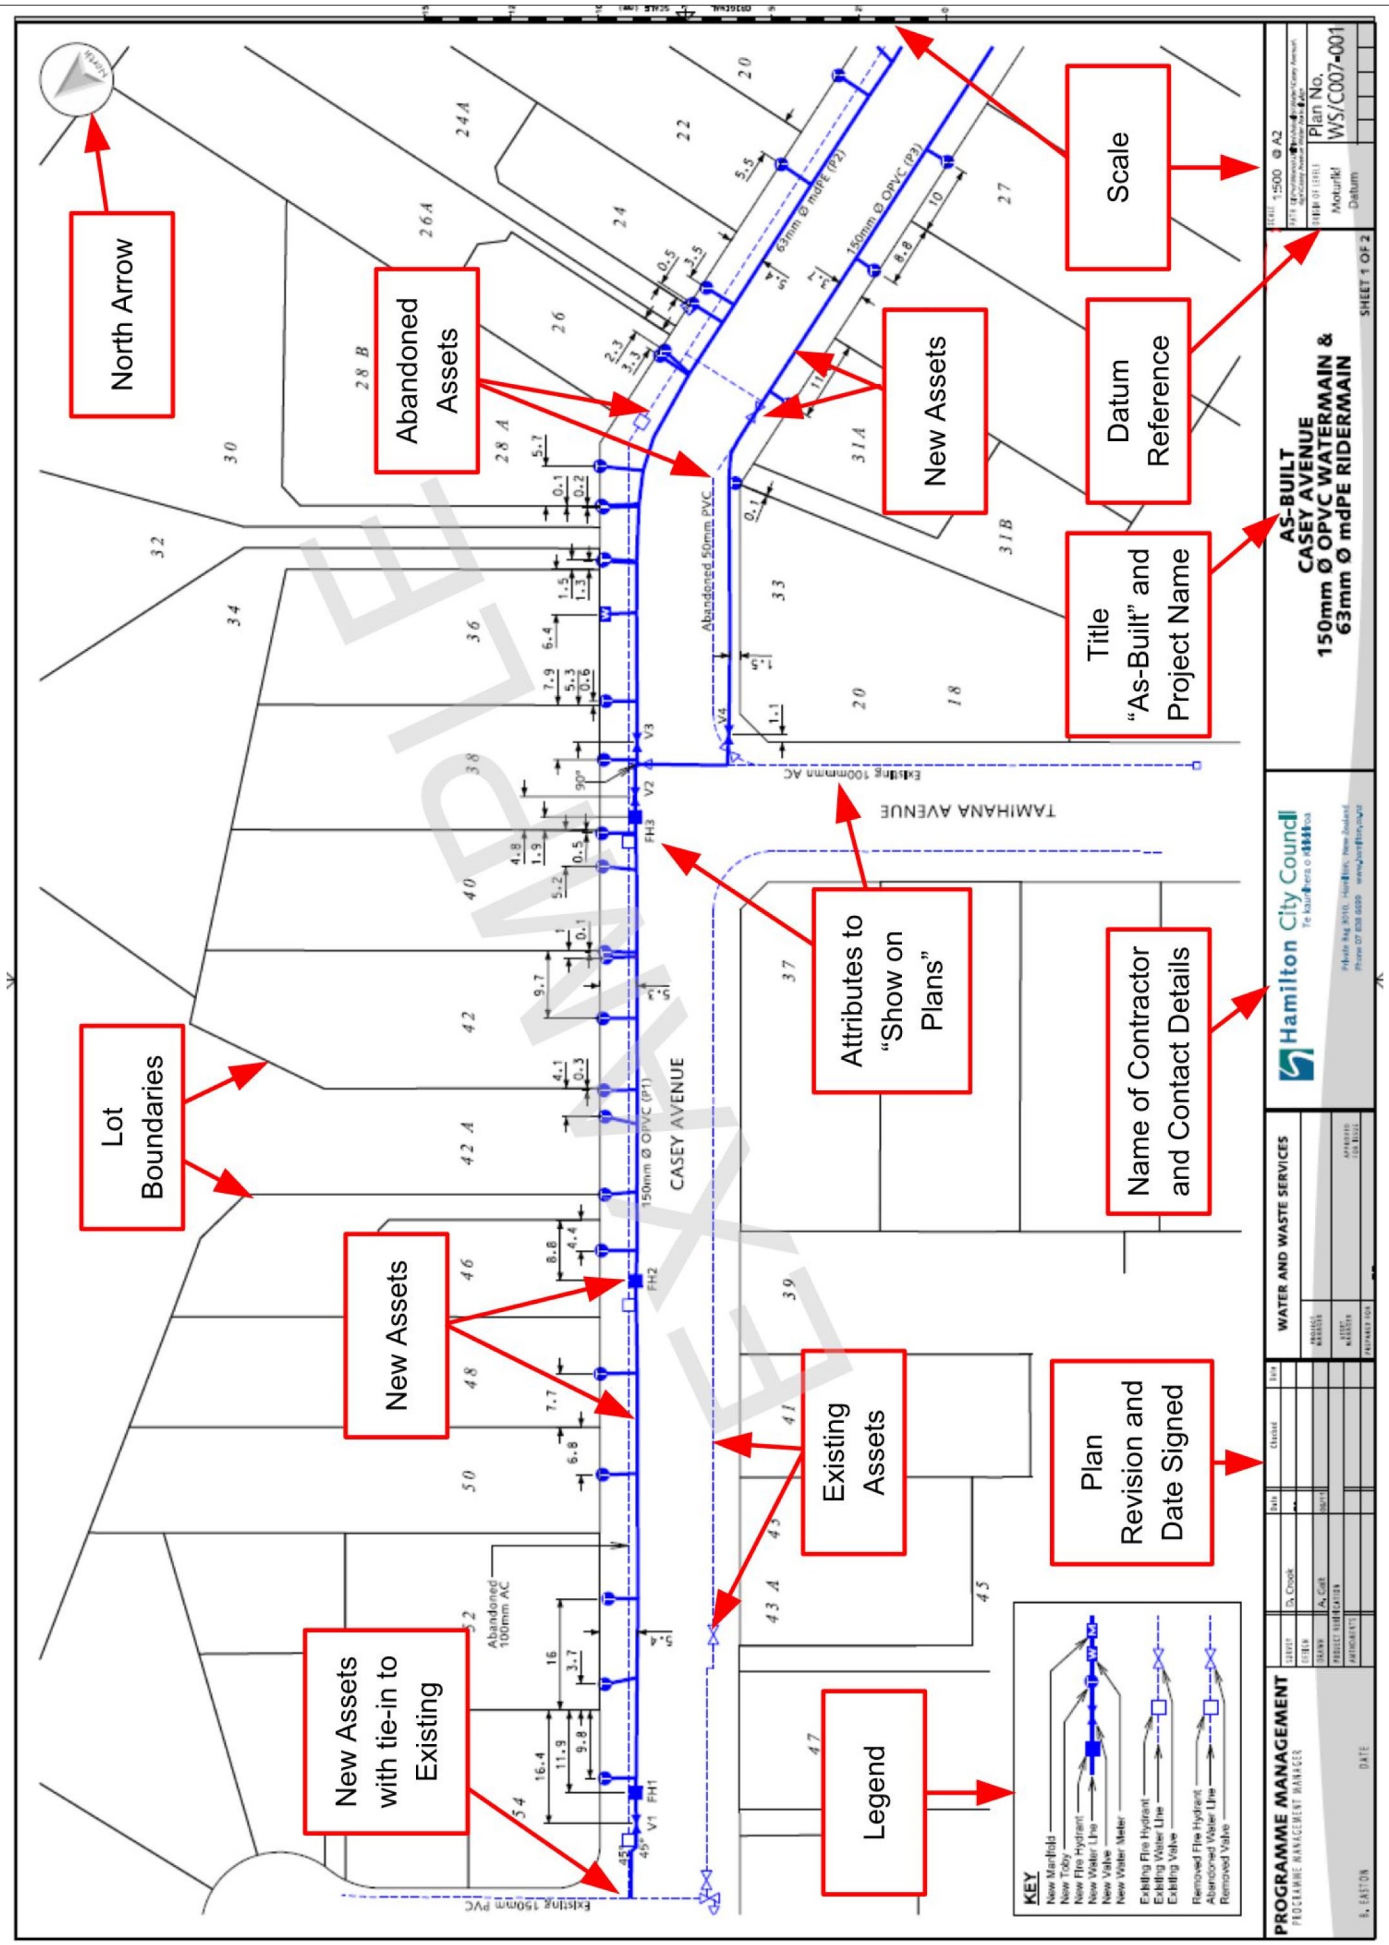

WATER AS-BUILT PLAN